THIS DRAWING IS COPYRIGHT AND SHALL NOT BE REPRODUCED WITHOUT THE PERMISSION OF THE ARCHITECTS

DO NOT SCALE FROM THIS DRAWING. USE FIGURED DIMENSIONS ONLY

SOUTH EAST (FRONT) ELEVATION

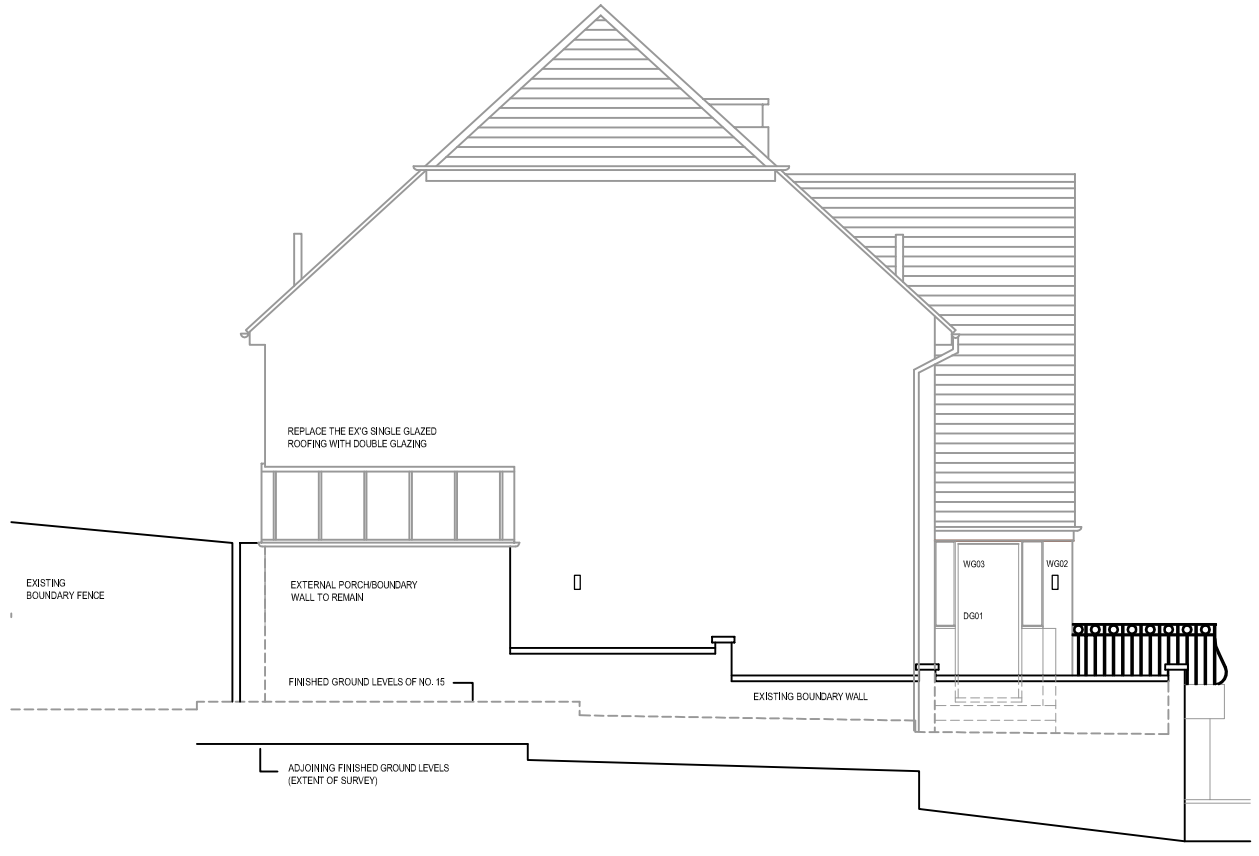

SOUTH WEST (SIDE ONE) ELEVATION

NORTH WEST (REAR) ELEVATION

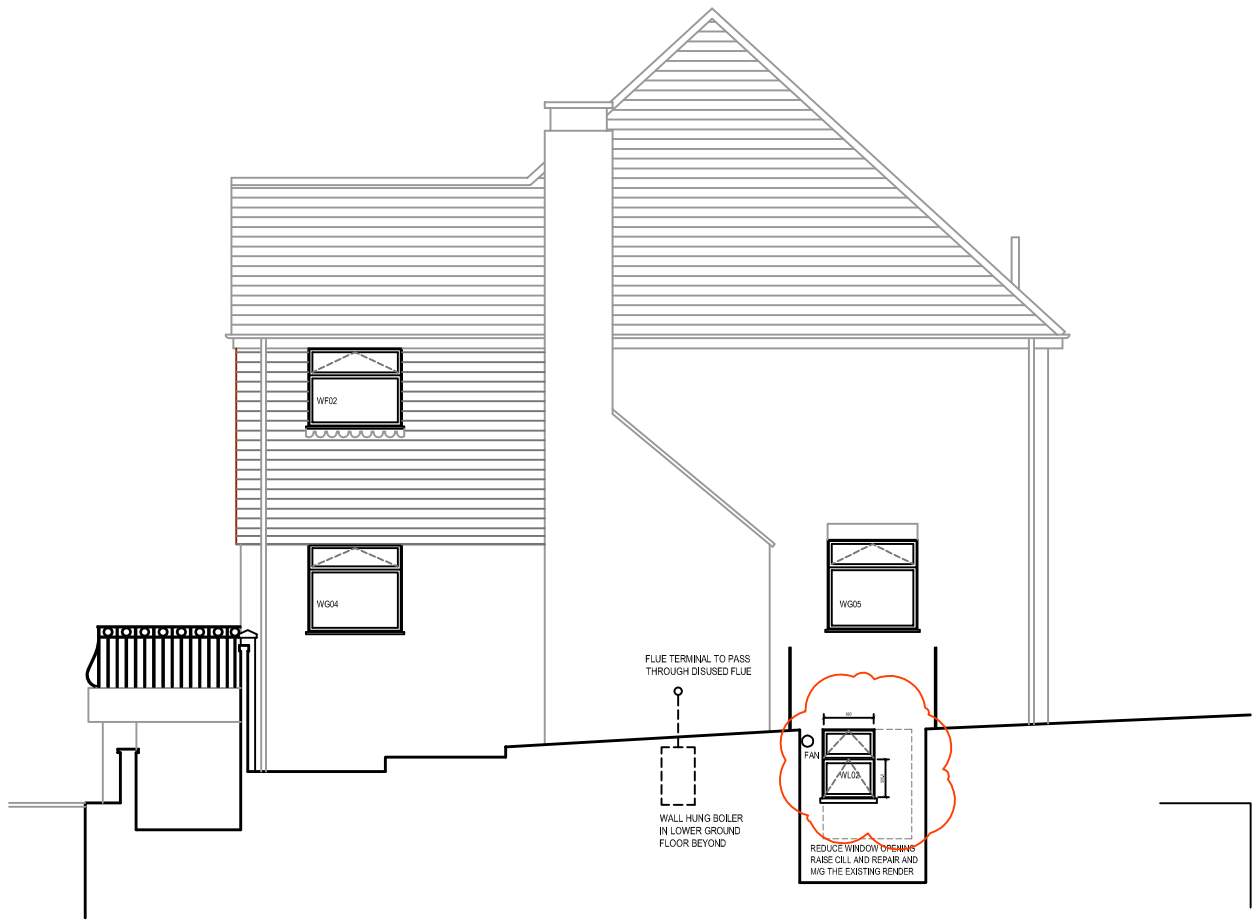

NORTH EAST (SIDE TWO) ELEVATION

N

0 1 2 3 4 5

metres

H 27.07.18 WINDOWS WL02 & WL03 AMENDED

G As built set — January 2018

AMENDMENTS

CLIENT EDWARD FARDELL
Thompson Snell & Passmore, acting for
PROF. R. GROVES

PROJECT 15 CRANEDOWN
LEWES, E.SUSSEX
BN7 3NA

TITLE PROPOSED ELEVATIONS

SCALE 1:50 @ A1

DATE January 2016

DRAWN ais

NUMBER 285/14H

waterside architects ltd
SUITE S7 WATERSIDE CENTRE
NORTH STREET LEWES
EAST SUSSEX BN7 2PE
TEL+FAX: (01273) 480188
E-MAIL Info@wa-arch.co.uk

waterside architects ltd